



# Condition 36.

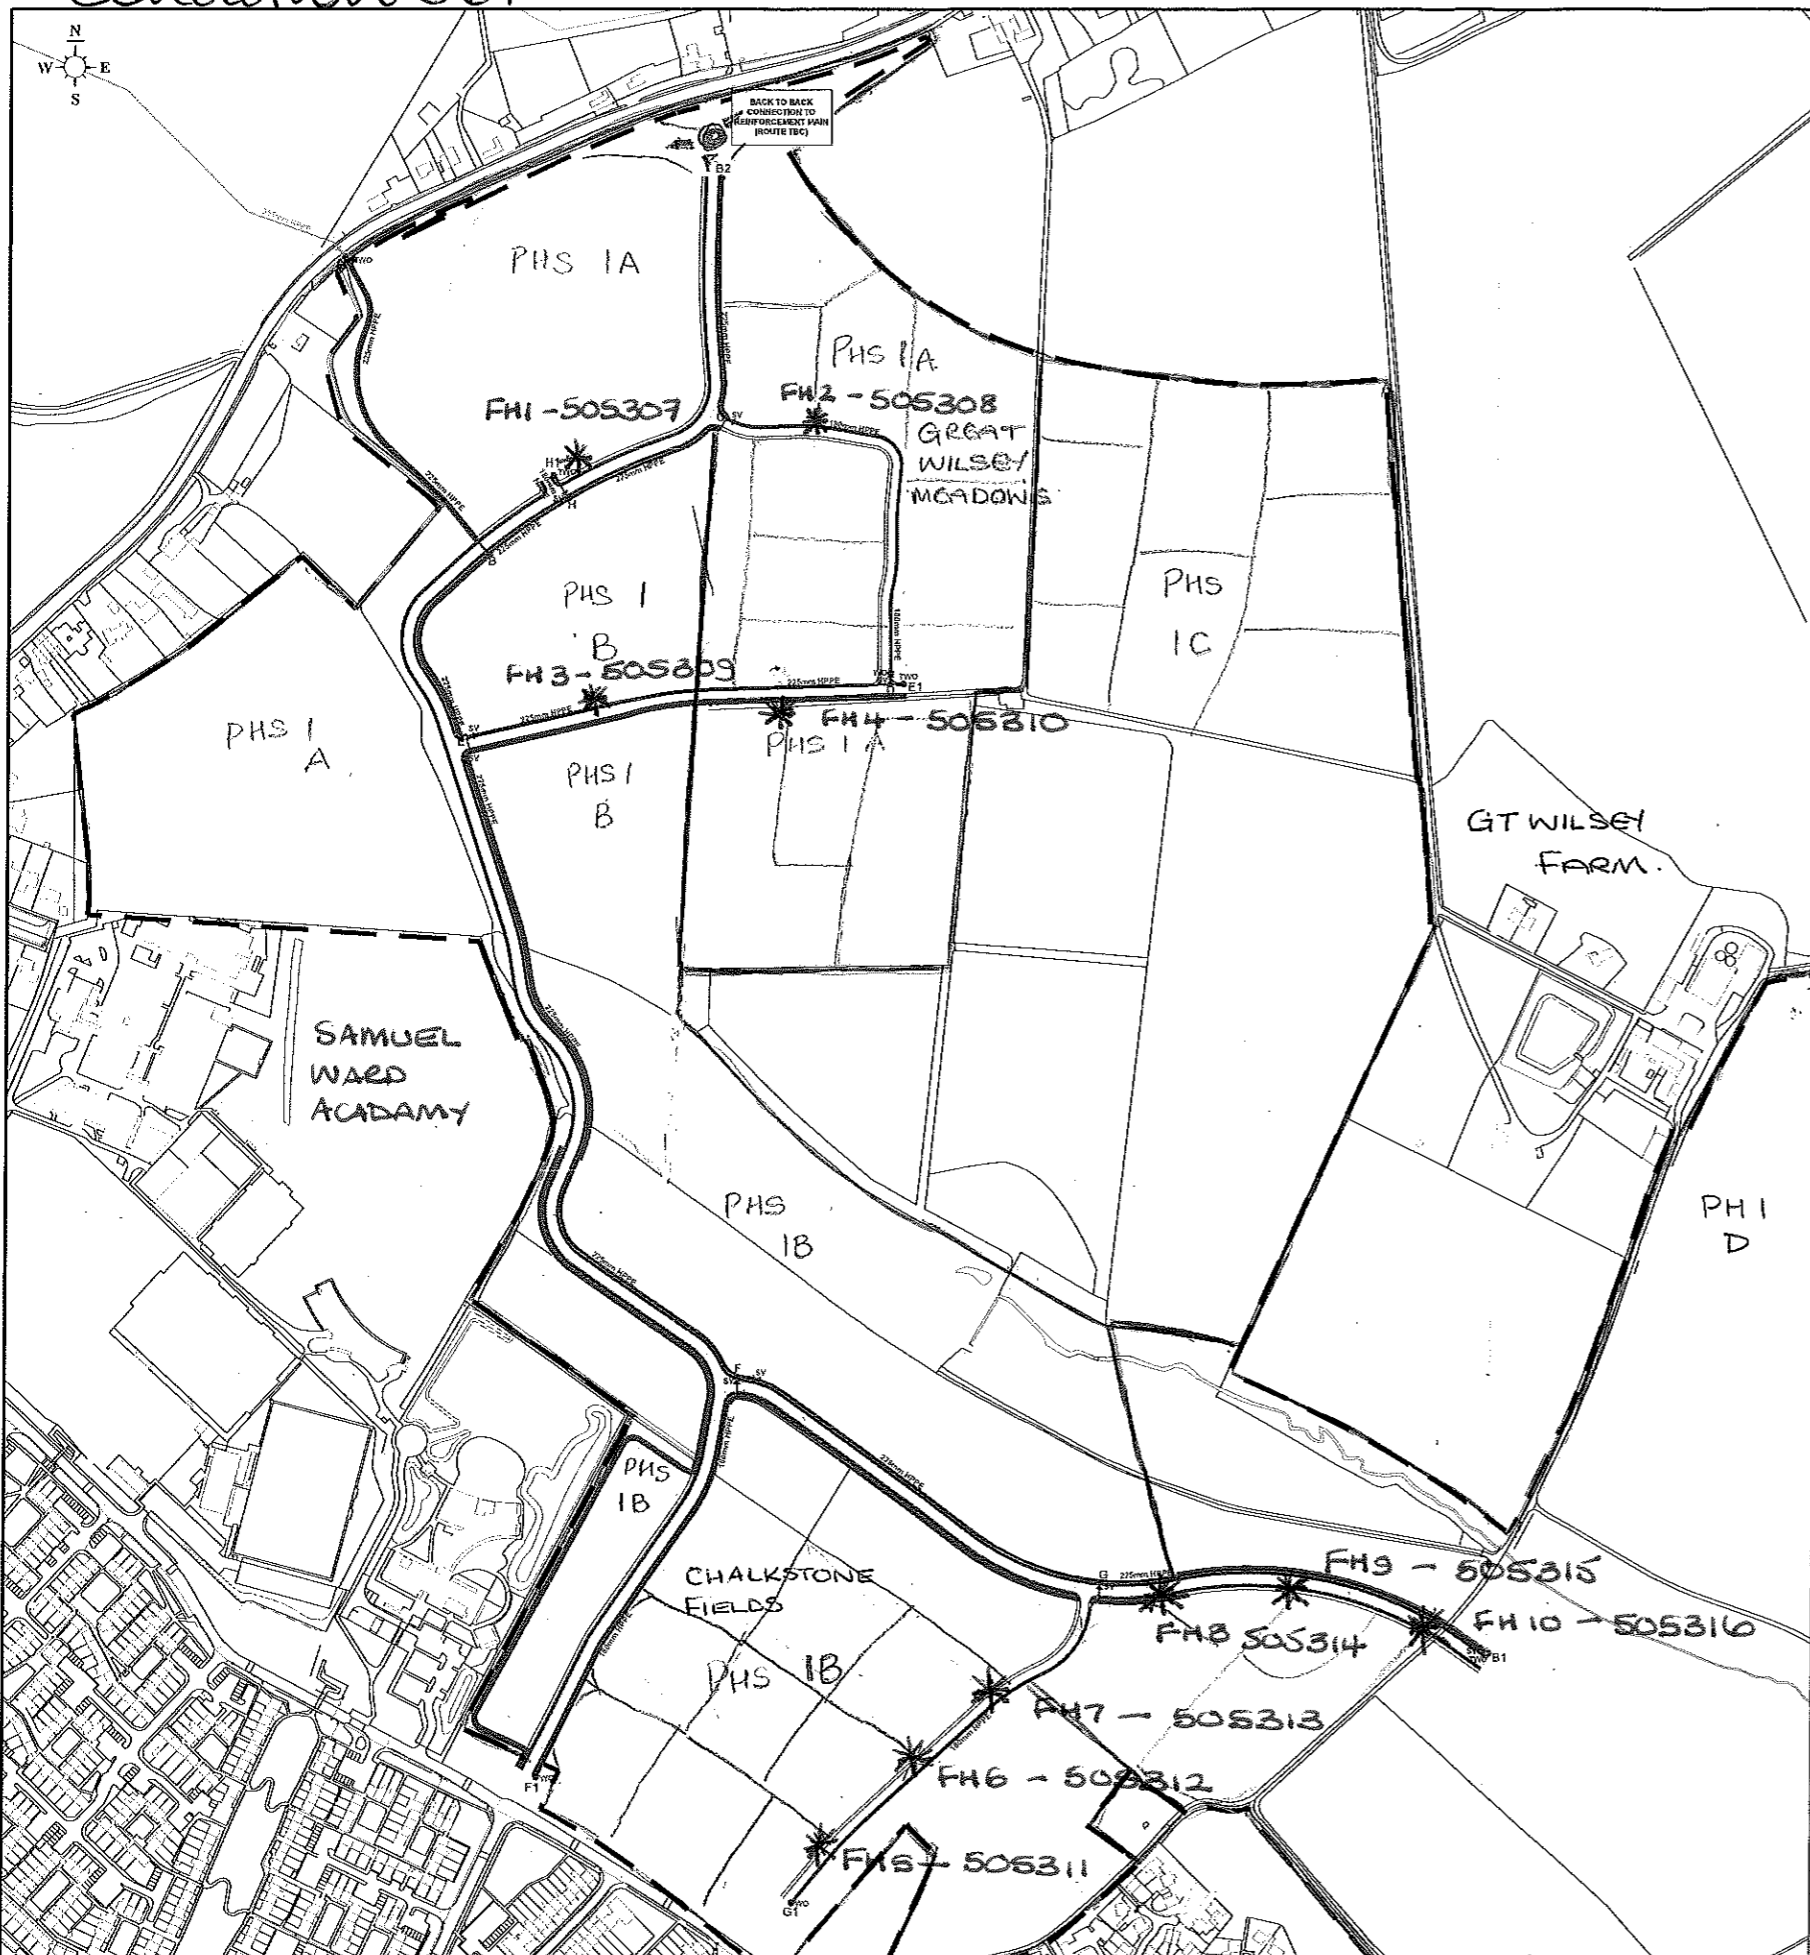

### PROPOSED MAINS EXTENSION SHOWN IN RED

A - B	238m	225mm HPPE
B - B1	1247m	225mm HPPE
B - B2	358m	225mm HPPE
C - D	284m	180mm HPPE
E - E1	304m	225mm HPPE
F - F1	311m	180mm HPPE
G - G1	313m	180mm HPPE
H - H1	19m	180mm HPPE

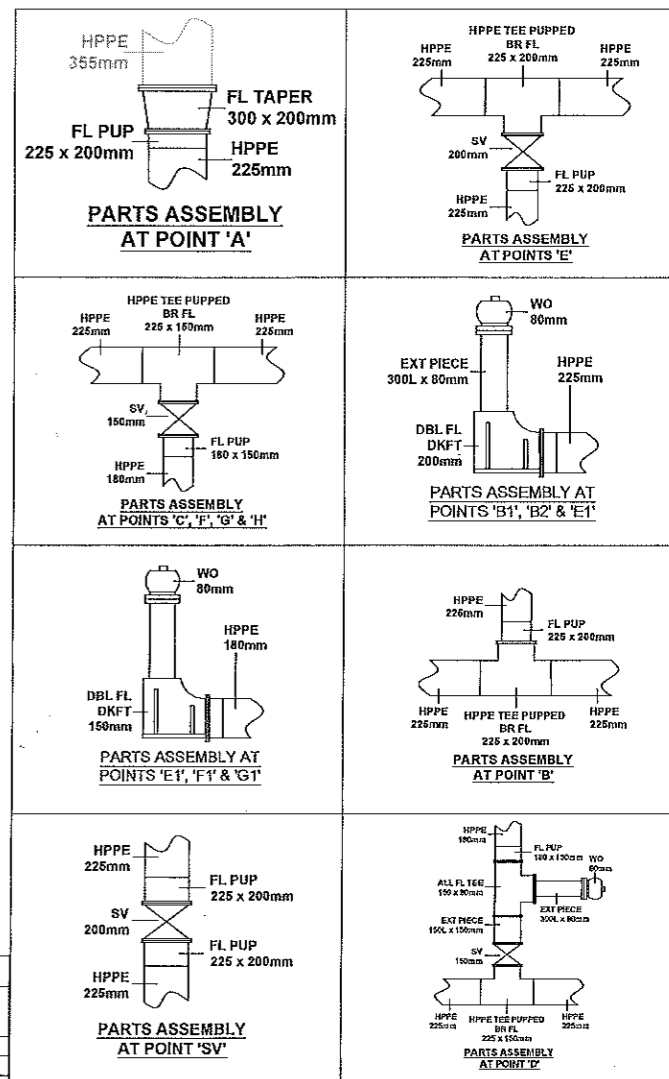

CDM Responsibilities			
Works denoted by red line.	Anglian Water	Anglian Water IMDS Contractor	Developer
Client			X
Principle Designer			X
Designer	X		
Principle Contractor			X
Contractor		X	

UTILITY INFORMATION	
Electricity	Low voltage overhead in Haverhill Road.
Gas	None shown.
BT	Overhead and underground services in Haverhill Road.
Virgin Media	None shown.
Water	As per this drawing.
Sewer	None shown.

**PART ASSEMBLY DIAGRAMS ARE NOT SCALED AND ARE ONLY TO AID MAINLAYING**

NOTES:  
 1. THERE SHOULD BE AN EASEMENT OF AT LEAST 2 METRES EITHER SIDE OF THE MAINS. THE FOOTINGS OF ANY BUILDING WITHIN THE EASEMENT AREA SHOULD BE AT LEAST 15 METRES DEEP.  
 2. SERVICE CONNECTION POINTS AND DUCT PLACEMENT ON THE DRAWING ARE FOR INDICATIVE PURPOSES ONLY TO AID IN IDENTIFYING THE NUMBER OF CONNECTIONS AND DUCTS REQUIRED. THESE POSITIONS ARE SUBJECT TO CHANGE BASED ON SITE SPECIFIC REQUIREMENTS AND/OR CHANGES IN THE WATER MAINS OR SITE LAYOUT. DEVELOPER TO INFORM ANGLIAN WATER OF ANY REQUIRED CHANGES.  
 FOR FURTHER INFORMATION PLEASE REFER TO THE GUIDELINES ON THE ANGLIAN WATER WEBSITE [www.a.wat.gov.uk](http://www.a.wat.gov.uk) OR TELEPHONE FOR ADVICE.

PROJECT AND DRAWING TITLE  
**Redrow Homes Eastern Ltd**  
 Spine Main, Great Wilsey Park  
 Haverhill, Suffolk, CB9 7TB

REV	DETAILS	BY	APP	DATE

**anglianwater**  
 Developer Services - IANS EAST  
 Heligam Way, Waterworks Road, Norwich, Norfolk, NR2 4DA  
 Tel: 01603 247074 Fax: 01603 247634  
 Design: [design@anglianwater.co.uk](mailto:design@anglianwater.co.uk)



LENGTH	DIAMETER	MAIN LAYING		
		MATERIAL	PIPE RATING	DUCT SIZE
10	225mm	HPPE	SDR11	500mm
10	180mm	HPPE	SDR17	300mm
10	150mm	HPPE	SDR17	250mm
10	125mm	HPPE	SDR17	200mm
10	100mm	HPPE	SDR17	150mm
10	75mm	HPPE	SDR17	100mm
10	50mm	HPPE	SDR21	50mm

DESIGNED: JW	DATE: 03.01.19	CHECKED: EW	DATE: 09.01.19
DRAWN: JW	DATE: 03.01.19	APPROVED: CP	DATE: 08.01.19
SCALE: As noted.	A1 Grid Ref.	568155, 246702	REV.
DRAWING No. 10542808			