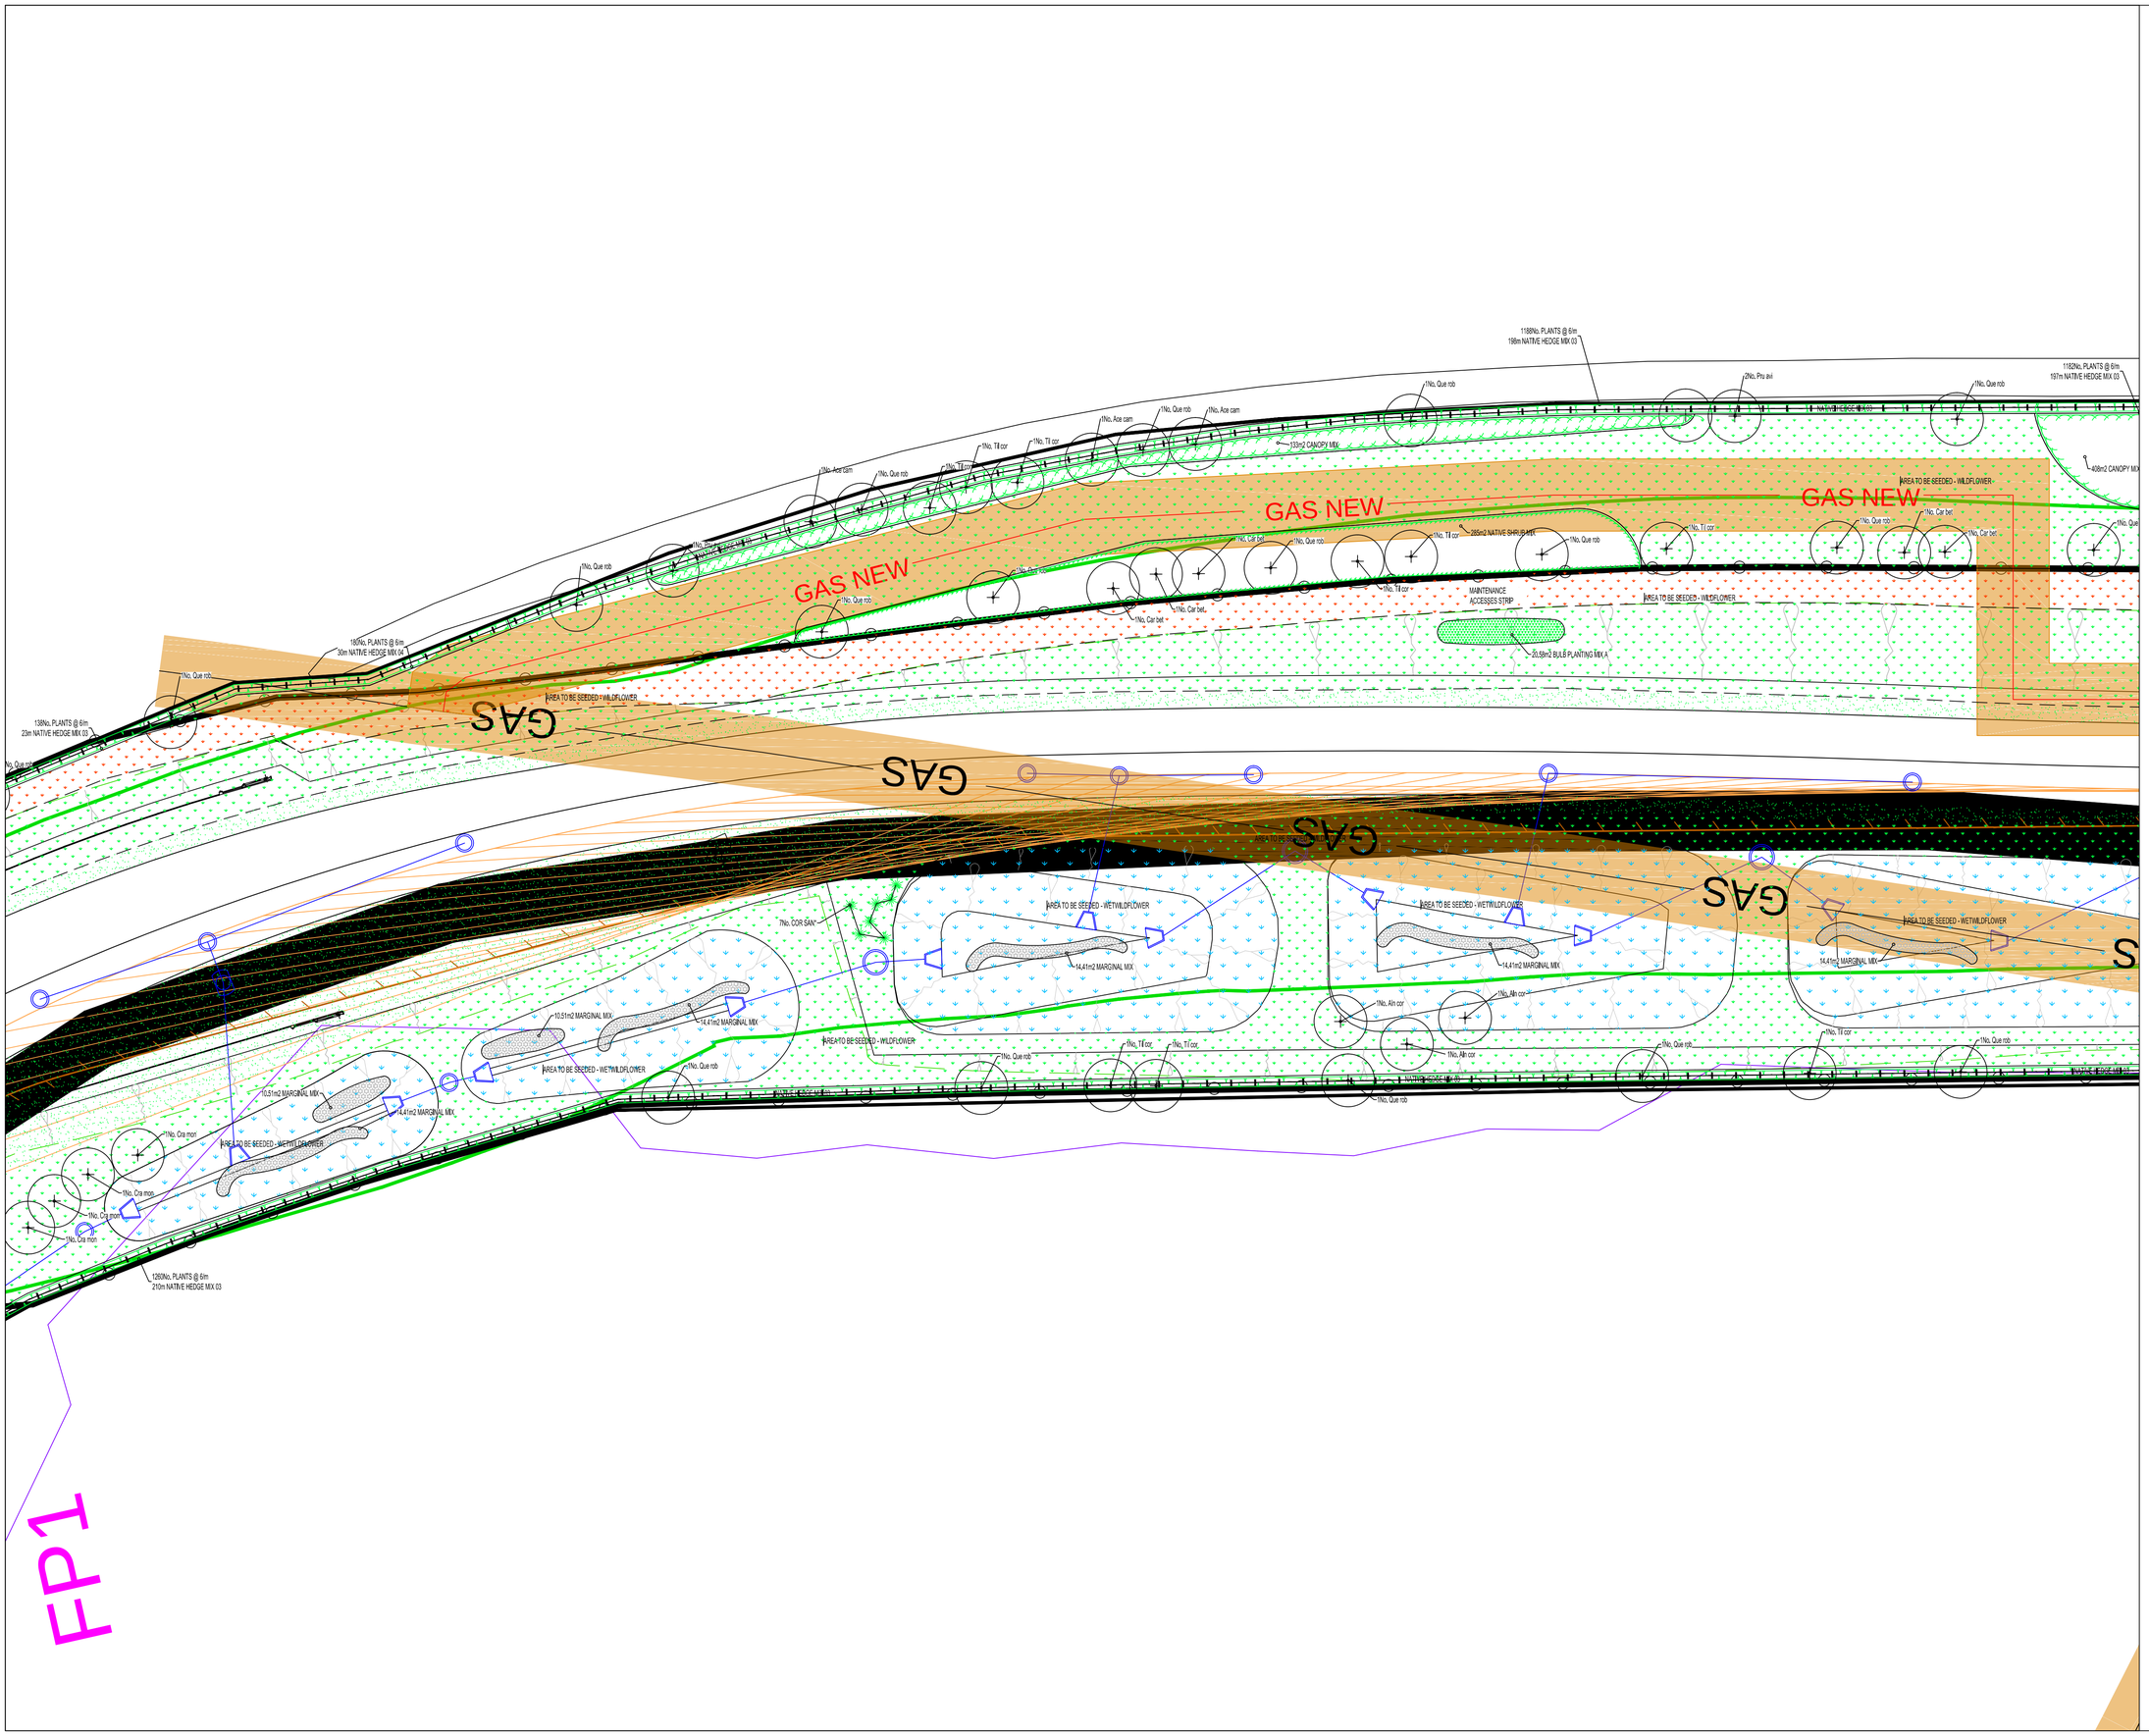

KEY

SOFT WORKS

- PROPOSED FEATHERED TREE, INCLUDING STAKE BIODEGRADABLE SPIRAL AND TIE. SEE SPECIFICATION NOTES A1, B2-3, B5, C1-4, D1-2 AND E1.
- PROPOSED STANDARD TREE, INCLUDING DOUBLE STAKE AND TIE. SEE SPECIFICATION NOTES A1, B2-3, B5, C1-4, D1-2 AND E1.
- PROPOSED HEAVY STANDARD TREE, INCLUDING DOUBLE STAKE AND TIE. SEE SPECIFICATION NOTES A1, B2-3, B5, C1-4, D1-2 AND E1.
- NATIVE WOODLAND, WHIP AND SHRUB PLANTING IN MIXES, INCLUDING BIODEGRADABLE SHEET AND BARK MULCH (ACCORDING TO SPECIFICATION. SEE SPECIFICATION NOTES A1-2, B1-3, C1-3, D1-2 AND E1. WHERE LARGE AREAS OF PLANTING ARE PROPOSED, PLANTS SHOULD BE USED WITH RABBIT PROOF MESH FENCING/NETTING RATHER THAN INDIVIDUAL SHRUBS
- HEDGE PLANTING, INCLUDING BIODEGRADABLE SHEET AND BARK MULCH (ACCORDING TO SPECIFICATION). REFER TO HEDGE SCHEDULES ON PLAN AND THE SCHEDULE OF QUANTITIES. SEE SPECIFICATION NOTES A1-2, B1-3, B5, C1-3, D1-2 AND E1.
- FLORAL LAWN SEEDED AREA. REFER TO PLANT SCHEDULE FOR SPECIFICATION OF MIX.
- SCC HIGHWAYS VERGE MIX UNLESS OTHERWISE STATED ON PLAN. SEE SPECIFICATION NOTES B4, C5 AND E1.
- WILDFLOWER MEADOW SEEDED AREA. REFER TO PLANT SCHEDULE FOR SPECIFICATION OF MIX.
- WETLAND WILDFLOWER SEEDED AREA. REFER TO PLANT SCHEDULE FOR SPECIFICATION OF MIX.
- MAINTENANCE ACCESS STRIP TO BE WILDFLOWER SEEDED AREA. REFER TO PLANT SCHEDULE FOR SPECIFICATION OF MIX.
- RIBBED ROOT BARRIER REROOT 1000.
- FOOTPATHS TO BE BITUMEN MACADAM. ALL DEPTHS TO ENGINEER'S SPECIFICATION AND ALL TO HIGHWAY'S AUTHORITY APPROVAL.
- RELIEF ROAD DCON BOUNDARY- REFERENCE DCON(H)/09/1283
- EXISTING TREE TO BE RETAINED. SEE GENERAL NOTE A1 AND E1. IF PREPARED, SEE ALSO JAMES BLAKE ASSOCIATES PLAN AND SCHEDULE FOR ANY SURGERY WORKS.
- EXISTING VEGETATION GROUP OR HEDGE TO BE RETAINED. SEE GENERAL NOTE A1 AND E1. IF PREPARED, SEE ALSO JAMES BLAKE ASSOCIATES PLAN AND SCHEDULE FOR ANY SURGERY WORKS.
- AREA TO BE RETAINED GROUND FLORA
- TREE PROTECTION FENCING - SEE JBA TREE PROTECTION PLANS FOR MORE DETAILS
- NATIVE SPECIMEN SHRUBS IN GRASS. TO BE EITHER WHIPS OR CONTAINER GROWN. SPECIMEN SHRUBS IN GRASS ARE MEASURED SEPARATELY IN SCHEDULE OF QUANTITIES. SEE SPECIFICATION NOTES A1, B1-3, C1-3, D1-2 AND E1.
- MARGINAL PLANTING. REFER TO PLANT SCHEDULE FOR SPECIFICATION OF MIX.
- TUSSOCK GRASSLAND. REFER TO PLANT SCHEDULE FOR SPECIFICATION OF MIX.
- CALCAREOUS GRASSLAND. REFER TO PLANT SCHEDULE FOR SPECIFICATION OF MIX.
- 3/2 -STRAND WIRE AND TIMBER POST FENCE. TO BE ERECTED THROUGH THE CENTRE OF THE STAGGERED ROW OF HEDGE.

REV.	DATE	INITIALS	DETAILS
L	19.05.23	CLR	UPDATED TO NEW LAYOUT AND ECO ENHANCEMENTS
K	22.04.22	CLR	UPDATED TO LPA COMMENTS AND NEW EASEMENT AND POND LAYOUT
J	27.01.22	CLR	UPDATED RED LINE BOUNDARY FOR RELIEF ROAD RECEIVED 14.01.22
I	22.07.21	CLR	REDLINE BOUNDARY FOR RELIEF ROAD UPDATED TO NEW LAYOUT RECEIVED 13.09.21
H	20.05.21	CLR	REVISED TO LATEST COMMENTS
G	28.06.21	CLR	UPDATED TO LATEST LAYOUTS
F	15.10.20	CR	UPDATED TO LPA COMMENTS AND LATEST LAYOUTS RECEIVED 16.09.20 AND 06.10.20
E	24.07.20	CR	UPDATED TO NEW RED LINE BOUNDARIES PLAN RECEIVED 17.07.20
D	15.11.19	AK	UPDATED TO LPA COMMENTS RECEIVED 11.11.19
C	13.02.19	CR	UPDATED TO LPA COMMENTS RECEIVED 18.01.19
B	12.12.18	CR	UPDATED TO NEW LAYOUTS RECEIVED 06.12.18
A	05.03.18	JM	UPDATED TO LPA COMMENTS

CLIENT PERSIMMON HOMES SUFFOLK	DWG. TITLE DETAILED SOFT LANDSCAPE PROPOSALS FOR INFRASTRUCTURE AREAS
SITE HAVERHILL RELIEF ROAD, HAVERHILL	
PURPOSE OF ISSUE PLANNING	

DRG BY	CHECKED	AUTH'D	SCALE	DATE	DWG NO.	REV.
JM	JBA	JBA	1:200@A1	JANUARY 2018	JBA17/364 11	L

JAMES BLAKE
ASSOCIATES
Head Office: 34-52 Out Westgate, Bury St Edmunds, Suffolk, IP33 3PA Tel. (01284) 335797
jamesblake@jba-landmarc.com www.jba-landmarc.com
LANDSCAPE ARCHITECTURE o ARBORICULTURE o ECOLOGY